
KEY NOTES - DETAIL 1

- 1) REMOVE (E) FIRE SPRINKLER WATERFLOW SWITCH, VALVE POSITION SUPERVISORY SWITCH, RACEWAY AND CIRCUITS TEMPORARILY INSTALLED FOR BUILDING 43.
- 2 INSTALL RACEWAY AND CIRCUITS AS SHOWN FOR THE FIRE ALARM DEVICES AND APPLIANCES FOR BUILDING 45 AND BUILDING 43.






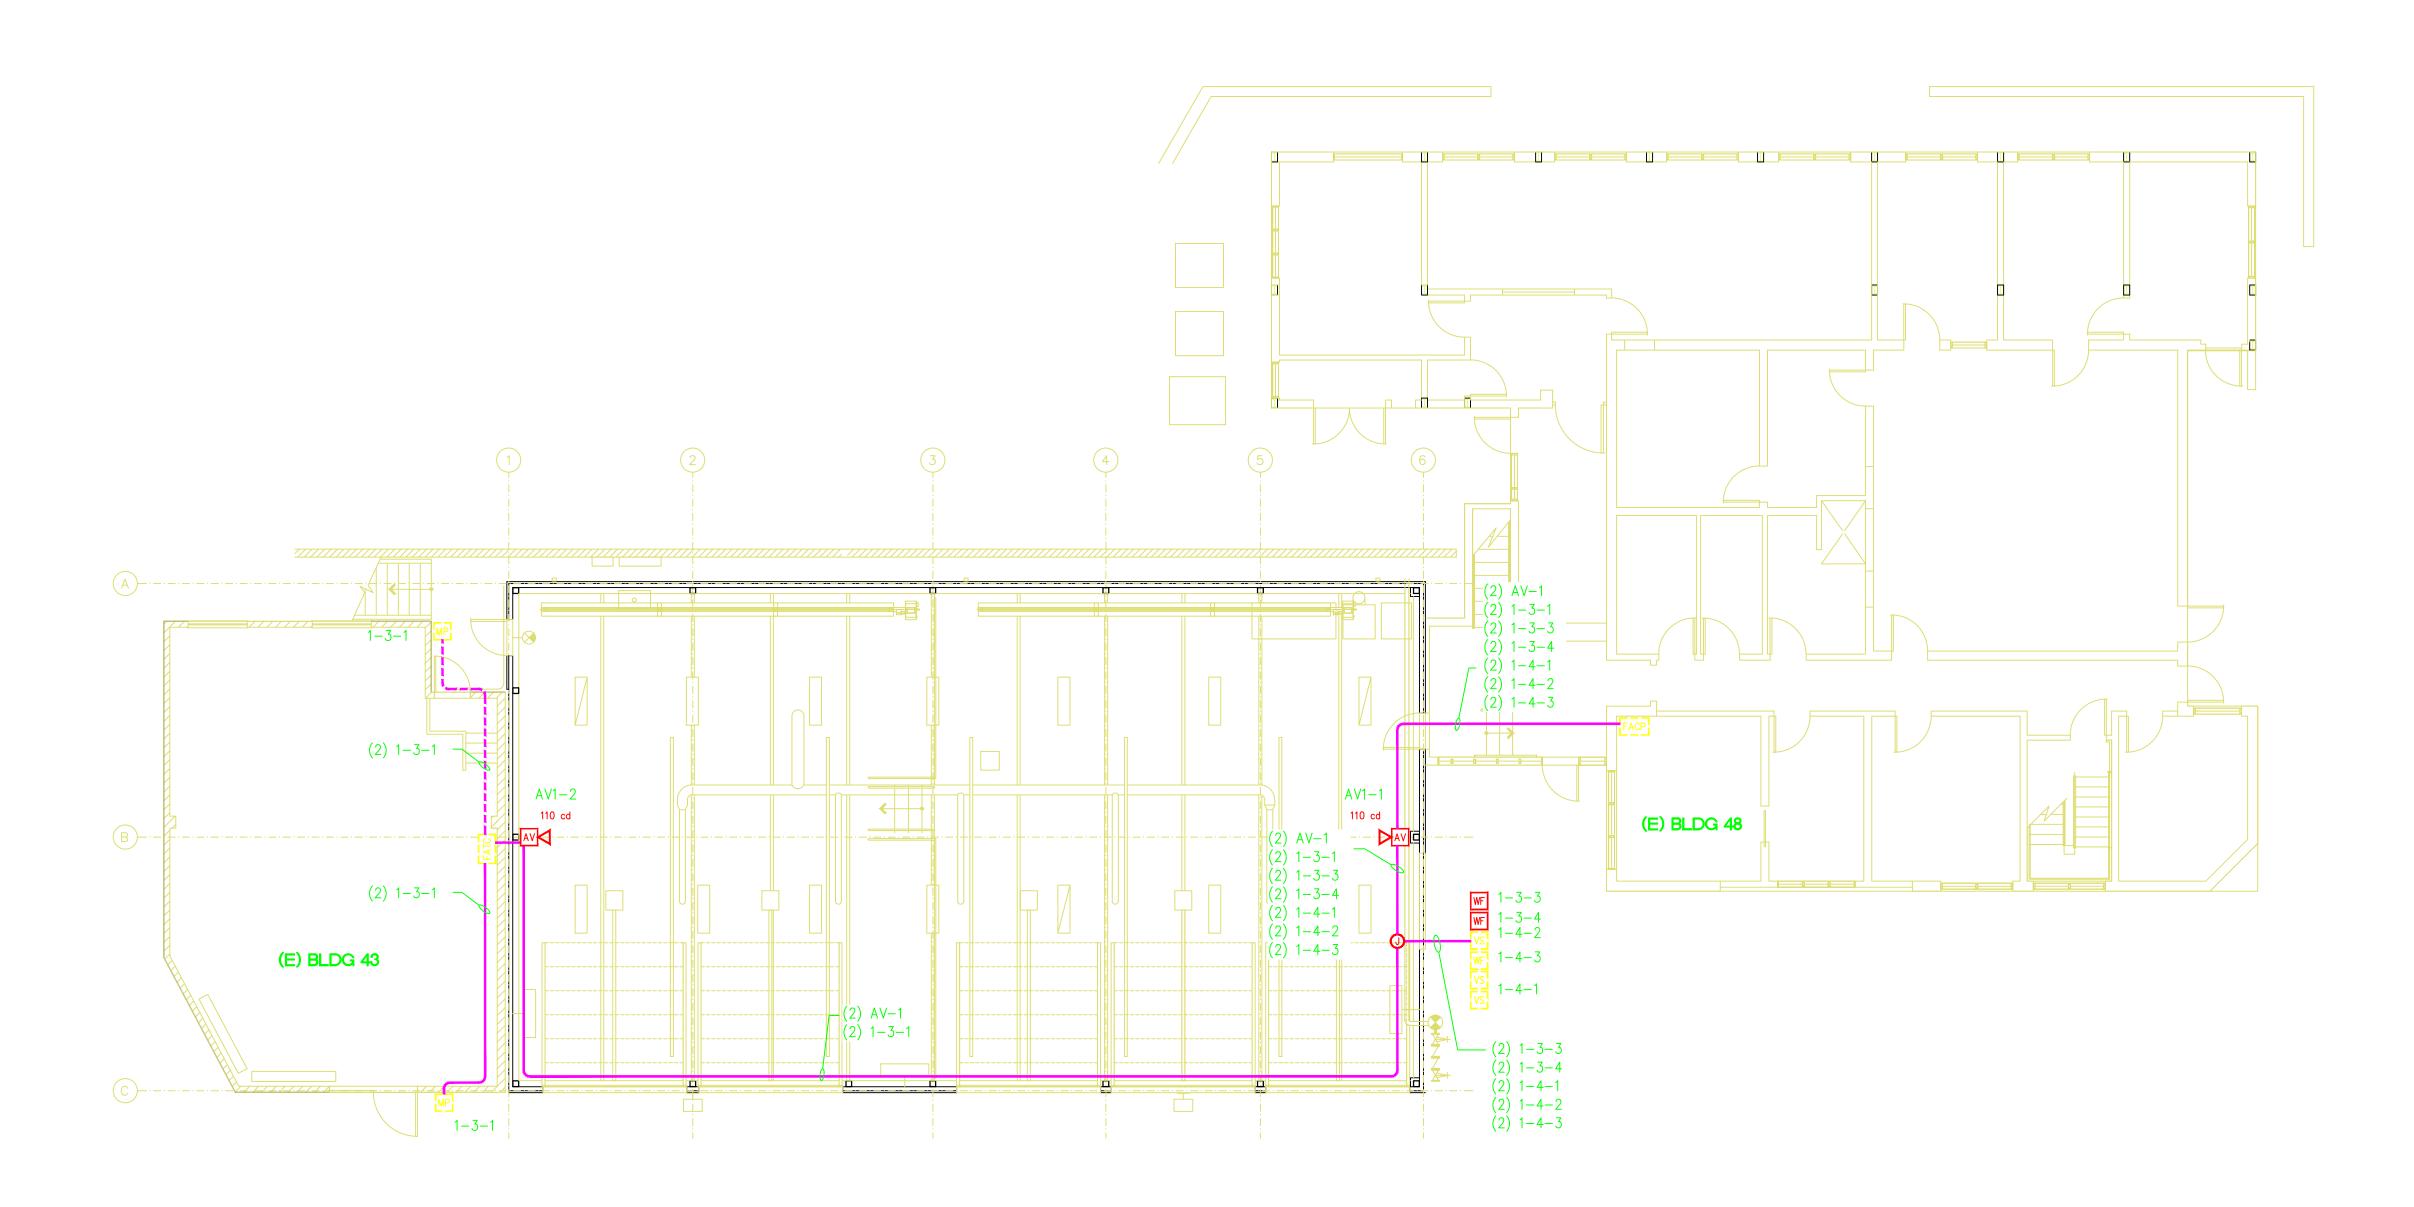

CONSULTING FIRM



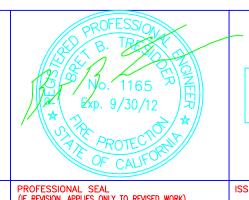

| E (PROGRESS, ESTIMATE, BID, CONSTRUCTION, CONFORMED, REVISION, AS-BUILT) | REVISION NUMBER | DRAWN BY | CHECKED BY | APPR'D BY | DATE | REMARKS |
|--|--------------------|-------------|---------------|--------------|----------|--|
| | 0 | HYT | HYT | | 09.30.11 | 75% CONSTRUCTION DOCUMENTS |
| | 1 | HYT | HYT | | 11.10.11 | 100% CONSTRUCTION DOCUMENTS |
| AS BUILT | 2 | HYT | HYT | | 12.02.11 | 100% CONSTRUCTION DOCUMENTS REVIEW COMME |
| | Α | HYT | HYT | | 05.22.13 | AS-BUILT RECORD DRAWING |
| RECORD DRAWING - | | | | | | |
| | | | | | | |
| | | | | | | |

| BUILDING 45 |
|-----------------------------|
| DUILDING 43 |
| FIRE STATION REPLACEMENT |
| I TINE STATION NET LAGEWENT |
| |

FIRE ALARM - FINAL

| FACILITIES DIVISION | PROJECT NO. |
|--|-----------------------|
| UNIVERSITY OF CALIFORNIA LAWRENCE BERKELEY NATIONAL LABORATORY | DRAWING NO. 4B45E027A |
| TINE ALAKW - TINAL TEAN | SCALE AS NOTED |
| FIRE ALARM — FINAL PLAN | CAD FILE PATH |

CHECKED BY HYT

APPROVED BY

DATE 05.22.13

05.22.13

FA2.0

39 OF 43